


**Proposed Over Approved Elevation on Triq Wigi Ebejer**  
Scale 1:100

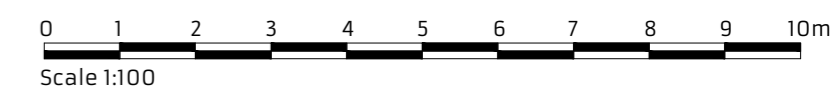

(1) This drawing is the sole property of the architect. It should not be copied or transmitted by any means, in whole or in part, without the permission of the architect.

(2) All dimensions are in millimeters unless stated otherwise and should not be scaled directly from the drawing. All dimensions are to be checked by the Contractor and are to be his responsibility.

(3) Any missing or conflicting information is to be reported to the Architect (Perit) in charge immediately upon discovery.

Project Title: Minor Amendment Of Basement Garages & Apartments	
Drawing Title: Proposed Over Approved Elevation on Triq Wigi Ebejer	
Drawing Number: MB - A032	Project Number: 2256

Client: Mr. Michael Bugeja	Site Address: Balzan
Architect: J.Farruga	Paper Size: A2
Drawn By: G.Fenech	Scale: As Shown
Checked By: D. Grima	Revision: 0
Date: 03 - 05 - 2021	

Notes:
Proposed Construction
Proposed Demolition
As Constructed To Sanction
Approved but not Constructed

	<b>Structural // Architectural // Solutions</b> 5/2, Collegiate Street, Birkirkara, Malta BKR 1361 m: (+356) 99878005 t: (+356) 27021706 e: info@sasmalta.com w: http://www.sasmalta.com
	Copyright© SAS Malta, 3rd May 2021