


**Proposed Over Approved Basement Level -1**  
Scale 1:100



(1) This drawing is the sole property of the architect. It should not be copied or transmitted by any means, in whole or in part, without the permission of the architect.  
 (2) All dimensions are in millimeters unless stated otherwise and should not be scaled directly from the drawing. All dimensions are to be checked by the contractor and are to be his responsibility.  
 (3) Any missing or conflicting information is to be reported to the architect (Perit) in charge immediately upon discovery.


Project Title: <b>Minor Amendment Of Basement Garages &amp; Apartments</b>		Client: <b>Mr. Michael Bugaja</b>		Site Address: <b>Balzan</b>		Notes:	
Drawing Title: <b>Proposed Over Approved Basement Level -1</b>		Architect: <b>J. Farrugia</b>		Paper Size: <b>AZ</b>		<input checked="" type="checkbox"/> Proposed Construction <input type="checkbox"/> Proposed Demolition <input type="checkbox"/> As Constructed To Sanction <input type="checkbox"/> Approved but not Constructed	
Drawing Number: <b>MB - A021</b>		Project Number: <b>2256</b>		Checked By: <b>D. Grima</b>			
		Date: <b>27 - 05 - 2021</b>		Revision:			
				0   1   2   3   4   5   6   7   8   9   10m			
						<b>Structural // Architectural // Solutions</b> 5/2, Colliette Street, Birkirkara, Malta BKR 1361 m: (+356) 99879005 t: (+356) 27021706 e: info@sasmalta.com w: http://www.sasmalta.com	
				Copyright © SAS Malta, 27th May 2021			

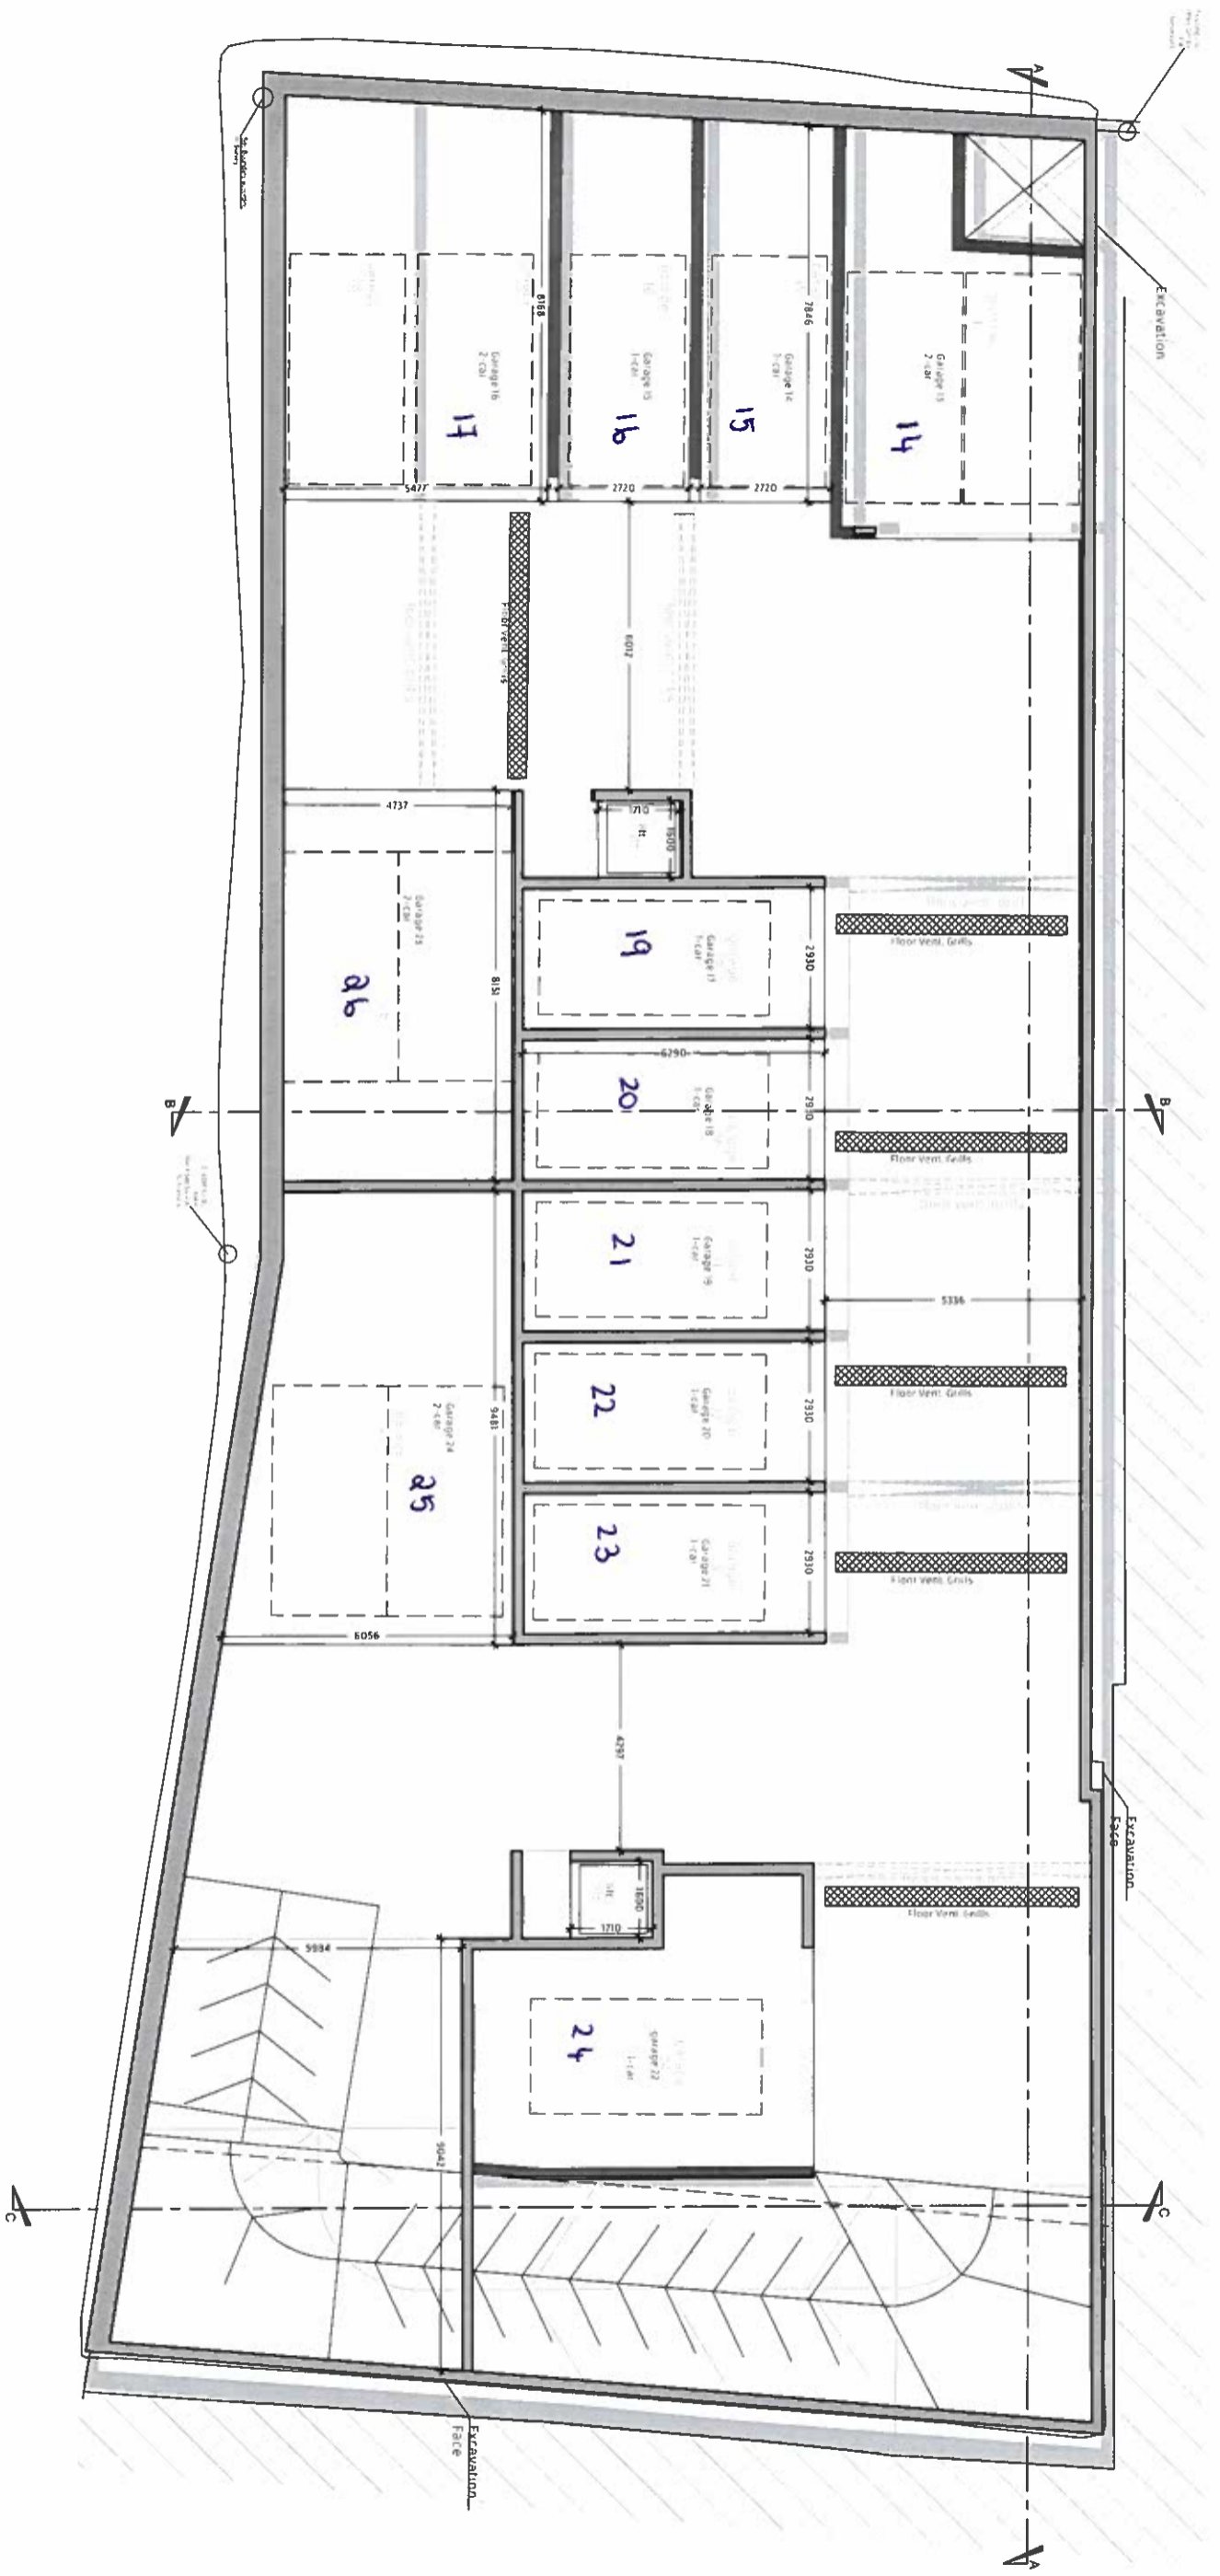

**Proposed Over Approved Basement Level -2**  
Scale 1:100



<p>(1) This drawing is the sole property of the architect. It should not be copied or transmitted by any means, in whole or in part, without the permission of the architect.</p> <p>(2) All dimensions are in millimeters unless stated otherwise and should not be scaled directly from the drawing. All dimensions are to be checked by the Contractor and are to be his responsibility.</p> <p>(3) Any missing or conflicting information is to be reported to the Architect (Pent) in charge immediately upon discovery.</p>		<p>Project Title: <b>Minor Amendment Of Basement Garages &amp; Apartments</b></p> <p>Drawing Title: <b>Proposed Over Approved Basement Level -2</b></p> <p>Drawing Number: <b>MB - A020</b></p> <p>Project Number: <b>2256</b></p>		<p>Client: <b>Mr. Michael Bugeja</b></p> <p>Architect: <b>J. Farruga</b></p> <p>Drawn By: <b>G. Fenech</b></p> <p>Checked By: <b>D. Grima</b></p> <p>Date: <b>27 - 05 - 2021</b></p>		<p>Site Address: <b>Balzan</b></p> <p>Paper Size: <b>A2</b></p> <p>Scale: <b>AS SHOWN</b></p> <p>Revision: <table border="1"> <tr> <td>0</td> <td>1</td> <td>2</td> <td>3</td> <td>4</td> <td>5</td> <td>6</td> <td>7</td> <td>8</td> <td>9</td> </tr> <tr> <td></td> <td></td> <td></td> <td></td> <td></td> <td></td> <td></td> <td></td> <td></td> <td></td> </tr> </table></p>		0	1	2	3	4	5	6	7	8	9											<p>Notes</p> <ul style="list-style-type: none"> <li><span style="display: inline-block; width: 10px; height: 10px; background-color: #cccccc; border: 1px solid black; margin-right: 5px;"></span> Proposed Construction</li> <li><span style="display: inline-block; width: 10px; height: 10px; border: 1px dashed black; border-style: dashed; margin-right: 5px;"></span> Proposed Demolition</li> <li><span style="display: inline-block; width: 10px; height: 10px; background-color: #e0e0e0; border: 1px solid black; margin-right: 5px;"></span> AS Constructed To Sanct on</li> <li><span style="display: inline-block; width: 10px; height: 10px; border: 1px solid black; margin-right: 5px;"></span> Approved but not constructed</li> </ul>		<p><b>SAS MALTA</b></p> <p>Structural // Architectural // Solutions</p> <p>57, Collegiate Street, Birkirkara, Malta BKR 1361</p> <p>m: (+356) 99878005 t: (+356) 27021706 e: info@sasmalta.com w: http://www.sasmalta.com</p> <p>Copyright © SAS Malta, 27th May 2021</p>	
0	1	2	3	4	5	6	7	8	9																						

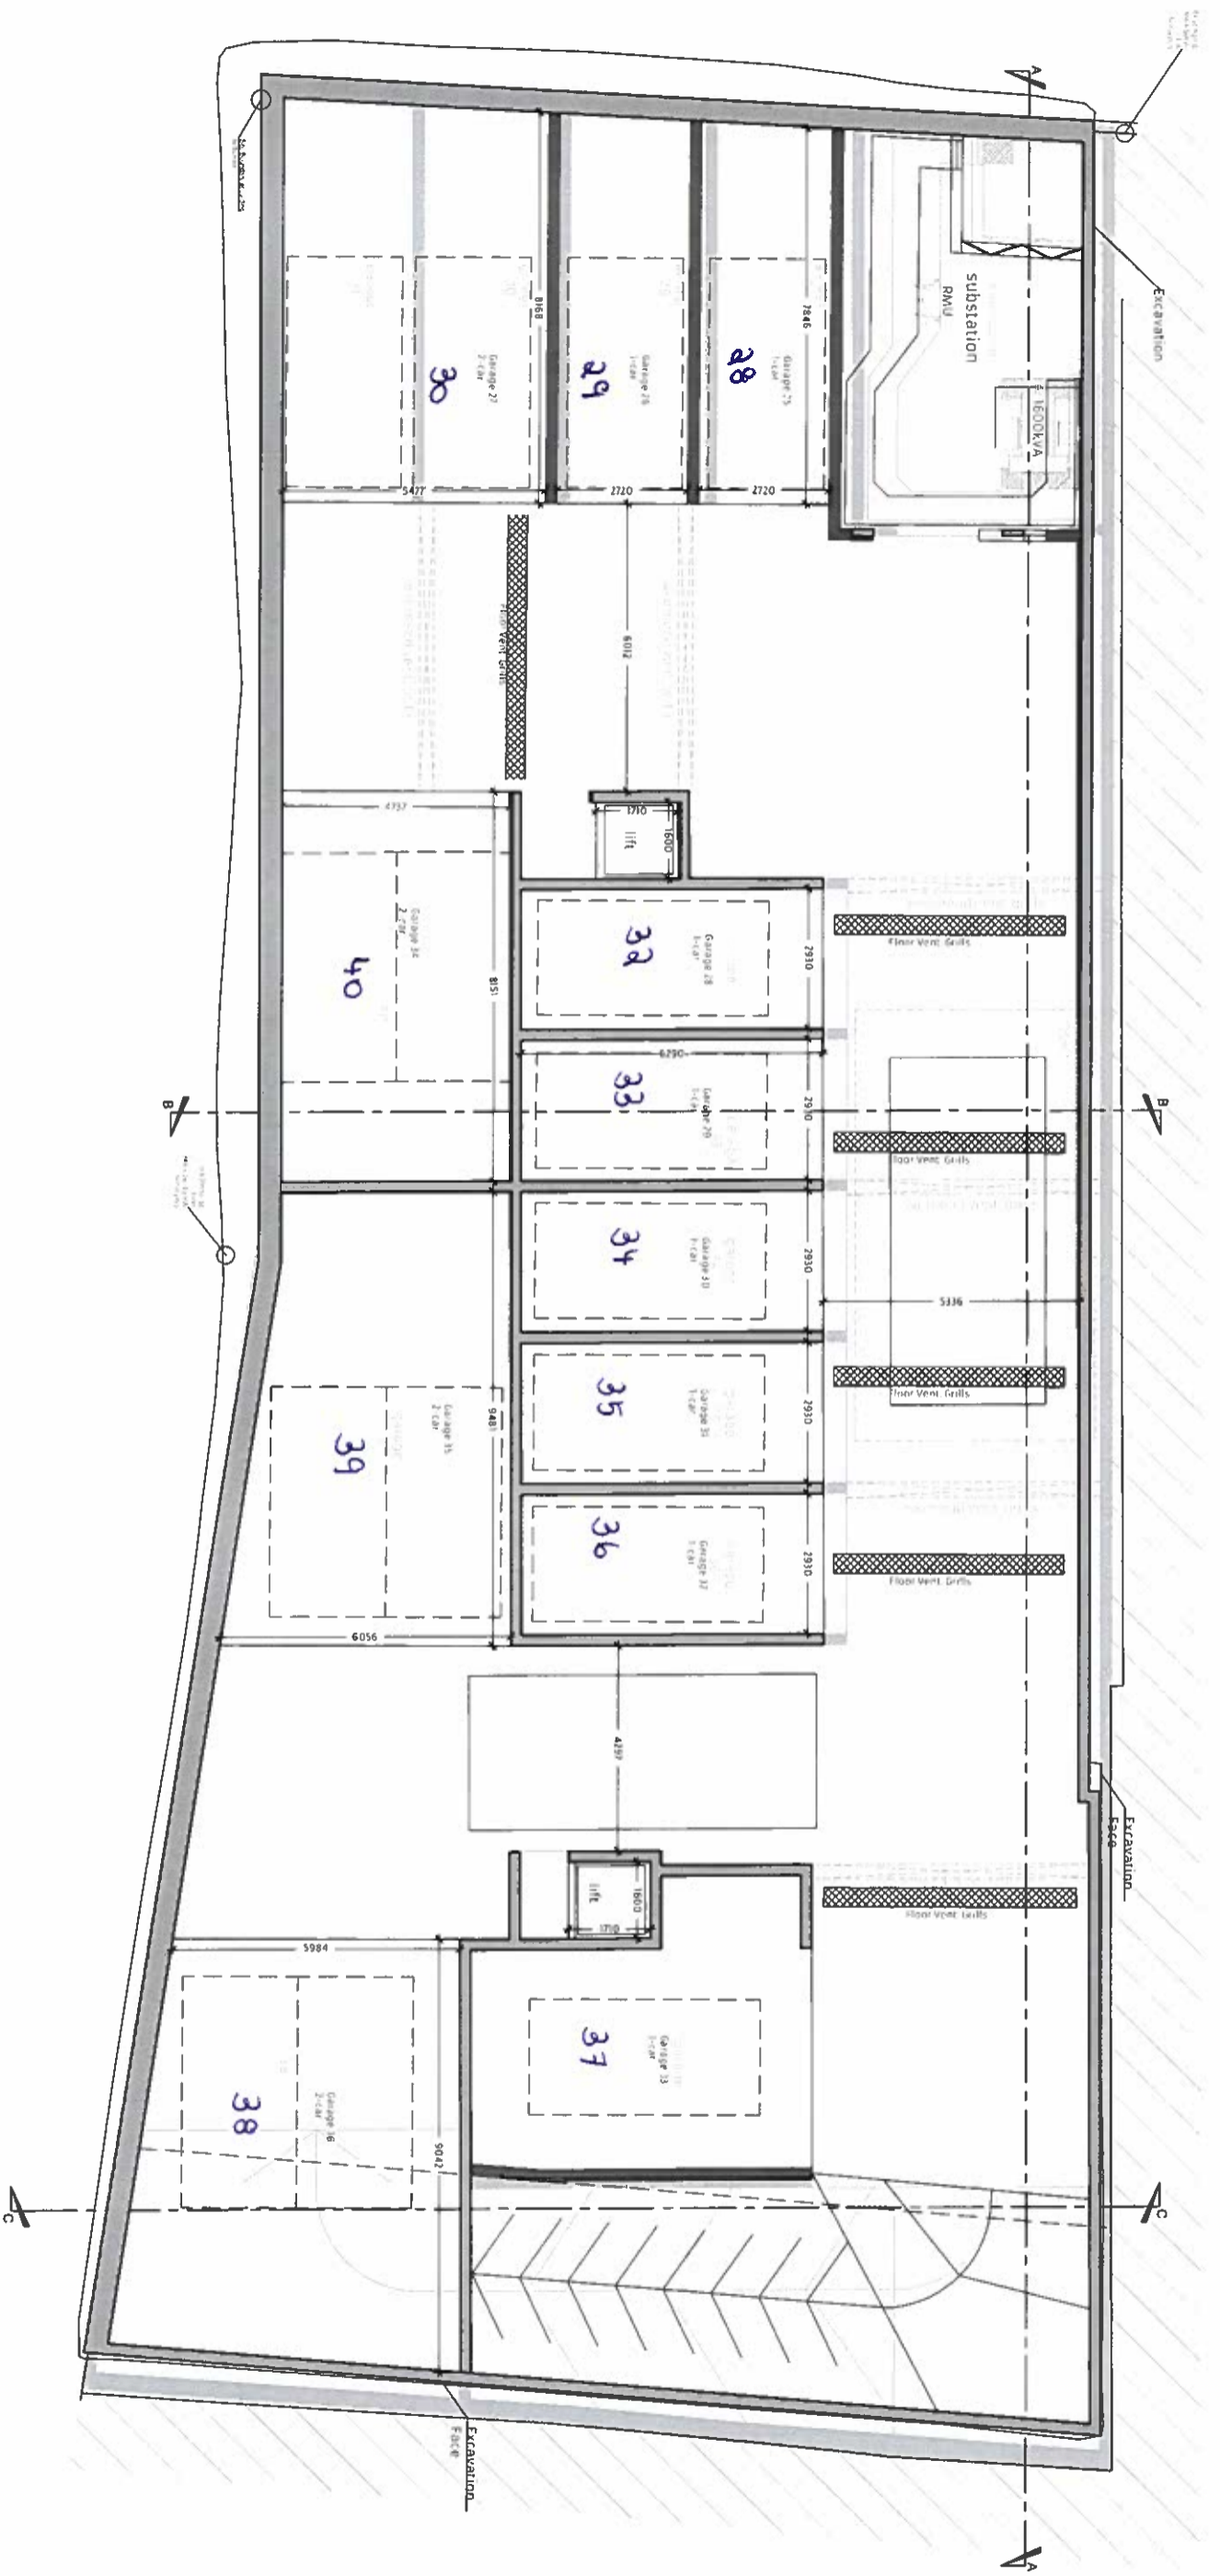

**Proposed Over Approved Basement Level -3**  
Scale 1:100



(1) This drawing is the sole property of the architect. It should not be copied or transmitted by any means, in whole or in part, without the permission of the architect.  
 (2) All dimensions are in millimeters unless stated otherwise and should not be scaled directly from the drawing. All dimensions are to be checked by the contractor and are to be his responsibility.  
 (3) Any missing or conflicting information is to be reported to the Architect (perit) in charge immediately upon discovery.

Project Title:	Minor Amendment Of Basement Garages & Apartments
Drawing Title:	Proposed Over Approved Basement Level -3
Drawing Number:	MB - A019
Project Number:	2256

Client:	Mr. Michael Bugeja
Architect:	J Farruga
Drawn By:	G.Fenech
Checked By:	D. Grima
Date:	27-05-2021

Site Address:	Balzan
Paper Size:	A2
Scale:	AS SHOWN
Revision:	0   1   2

Notes:	<input checked="" type="checkbox"/> Proposed Construction <input type="checkbox"/> Proposed Demolition <input checked="" type="checkbox"/> As Constructed to Sanction <input type="checkbox"/> Approved but not constructed
--------	--

**SAS**  
M A L T A

Structural // Architectural // Solutions  
 5/2, Collegate Street, Birkirkara, Malta BKR 1361  
 M: (+356) 99878005  
 T: (+356) 27021705  
 E: info@sasmalta.com  
 W: http://www.sasmalta.com

Copyright © SAS Malta, 27th May 2021