


Proposed Over Approved 2nd Floor
Scale 1:100

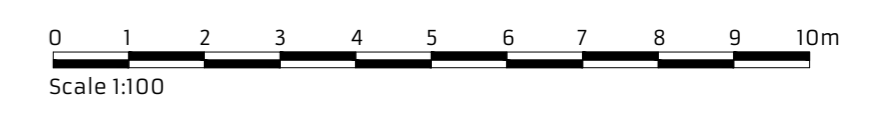

(1) This drawing is the sole property of the architect. It should not be copied or transmitted by any means, in whole or in part, without the permission of the architect.


(2) All dimensions are in millimeters unless stated otherwise and should not be scaled directly from the drawing. All dimensions are to be checked by the Contractor and are to be his responsibility.

(3) Any missing or conflicting information is to be reported to the Architect (Perit) in charge immediately upon discovery.

Project Title: Minor Amendment Of Basement Garages & Apartments	
Drawing Title: Proposed Over Approved 2nd Floor	
Drawing Number: MB - A024	Project Number: 2256

Client: Mr. Michael Bugeja	Site Address: Balzan
Architect: J.Farruga	Paper Size: A2
Drawn By: G.Fenech	Scale: As Shown
Checked By: D. Grima	Revision: 0 1 2
Date: 27 - 05 - 2021	

- Notes:
- Proposed Construction
 - Proposed Demolition
 - As Constructed To Sanction
 - Approved but not Constructed



SAS
MALTA

Structural // Architectural // Solutions
5/2, Collegiate Street, Birkirkara, Malta BKR 1361
m: (+356) 99878005
t: (+356) 27021706
e: info@sasmalta.com
w: http://www.sasmalta.com

Copyright© SAS Malta, 27th May 2021