


Proposed Over Approved Section A-A
Scale 1:100

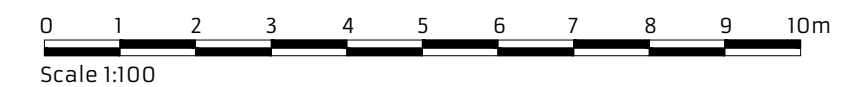

(1) This drawing is the sole property of the architect. It should not be copied or transmitted by any means, in whole or in part, without the permission of the architect.

(2) All dimensions are in millimeters unless stated otherwise and should not be scaled directly from the drawing. All dimensions are to be checked by the Contractor and are to be his responsibility.

(3) Any missing or conflicting information is to be reported to the Architect (Perit) in charge immediately upon discovery.

| | |
|--------------------------------------------------------------------|-------------------------|
| Project Title: Minor Amendment Of Basement Garages & Apartments | |
| Drawing Title: Proposed Over Approved Section A-A | |
| Drawing Number: MB - A040 | Project Number: 2256 |

| | |
|-------------------------------|-------------------------|
| Client: Mr. Michael Bugeja | Site Address: Balzan |
| Architect: J.Farruga | Paper Size: A2 |
| Drawn By: G.Fenech | Scale: As Shown |
| Checked By: D. Grima | Revision: 0 |
| Date: 03 - 05 - 2021 | |

| |
|------------------------------|
| Notes: |
| Proposed Construction |
| Proposed Demolition |
| As Constructed To Sanction |
| Approved but not Constructed |

| | |
|--|---------------------------------------------------------------------------------------------------------------------------------------------------------------------------------------------------------|
| | Structural // Architectural // Solutions 5/2, Collegiate Street, Birkirkara, Malta BKR 1361 m: (+356) 99878005 t: (+356) 27021706 e: info@sasmalta.com w: http://www.sasmalta.com |
| | Copyright© SAS Malta, 3rd May 2021 |