




As built level 1
Scale 1:100

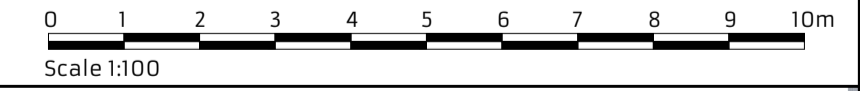

(1) This drawing is the sole property of the architect. It should not be copied or transmitted by any means, in whole or in part, without the permission of the architect.

(2) All dimensions are in millimeters unless stated otherwise and should not be scaled directly from the drawing. All dimensions are to be checked by the Contractor and are to be his responsibility.

(3) Any missing or conflicting information is to be reported to the Architect (Perit) in charge immediately upon discovery.

Project Title: Construction of two basements levels of 95 garages, two class 4B shops, six levels of apartments consisting of 82 units and 12 penthouses on a receded level.	
Drawing Title: As built level 1 - Clean	
Drawing Number: MB2 - A011	Project Number: 2030

Client: Mr. Michael Bugeja	Site Address: Triq San Gorg, San Pawl il-Bahar
Architect: D. Grima	Paper Size: A1
Drawn By: M. Camilleri	Scale: 1:100
Checked By: D. Grima	Revision: 01
Date: 14 - 06 - 2022	

Notes:
Proposed Construction
Proposed Demolition
As Constructed To Sanction
Approved but not Constructed

Structural // Architectural // Solutions
5/2, Collegiate Street, Birkirkara, Malta BKR 1361
m: (+356) 99878005
t: (+356) 27021706
e: info@sasmalta.com
w: http://www.sasmalta.com

Copyright © SASMalta, 14th June 2022