




As built level 3  
Scale 1:100

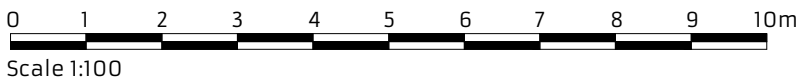

(1) This drawing is the sole property of the architect. It should not be copied or transmitted by any means, in whole or in part, without the permission of the architect.

(2) All dimensions are in millimeters unless stated otherwise and should not be scaled directly from the drawing. All dimensions are to be checked by the Contractor and are to be his responsibility.

(3) Any missing or conflicting information is to be reported to the Architect (Perit) in charge immediately upon discovery.

Project Title:  
Construction of two basements levels of 95 garages, two class 4B shops, six levels of apartments consisting of 82 units and 12 penthouses on a receded level.

Drawing Title:  
As built level 3 - Clean

Drawing Number:  
MB2 - A017

Project Number:  
2030

Client:  
Mr. Michael Bugeja

Architect:  
D. Grima

Drawn By:  
M.Camilleri

Checked By:  
D. Grima

Date:  
14 - 06 - 2022

Site Address:  
Triq San Gorg, San Pawl il-Bahar

Paper Size:  
A1

Scale:  
1:100

Revision:  
01

- Notes:
- Proposed Construction
  - Proposed Demolition
  - As Constructed To Sanction
  - Approved but not Constructed



Structural // Architectural // Solutions  
5/2, Collegiate Street, Birkirkara, Malta BKR 1361  
m: (+356) 99878005  
t: (+356) 27021706  
e: info@sasmalta.com  
w: http://www.sasmalta.com

Copyright© SASMalta, 14th June 2022